



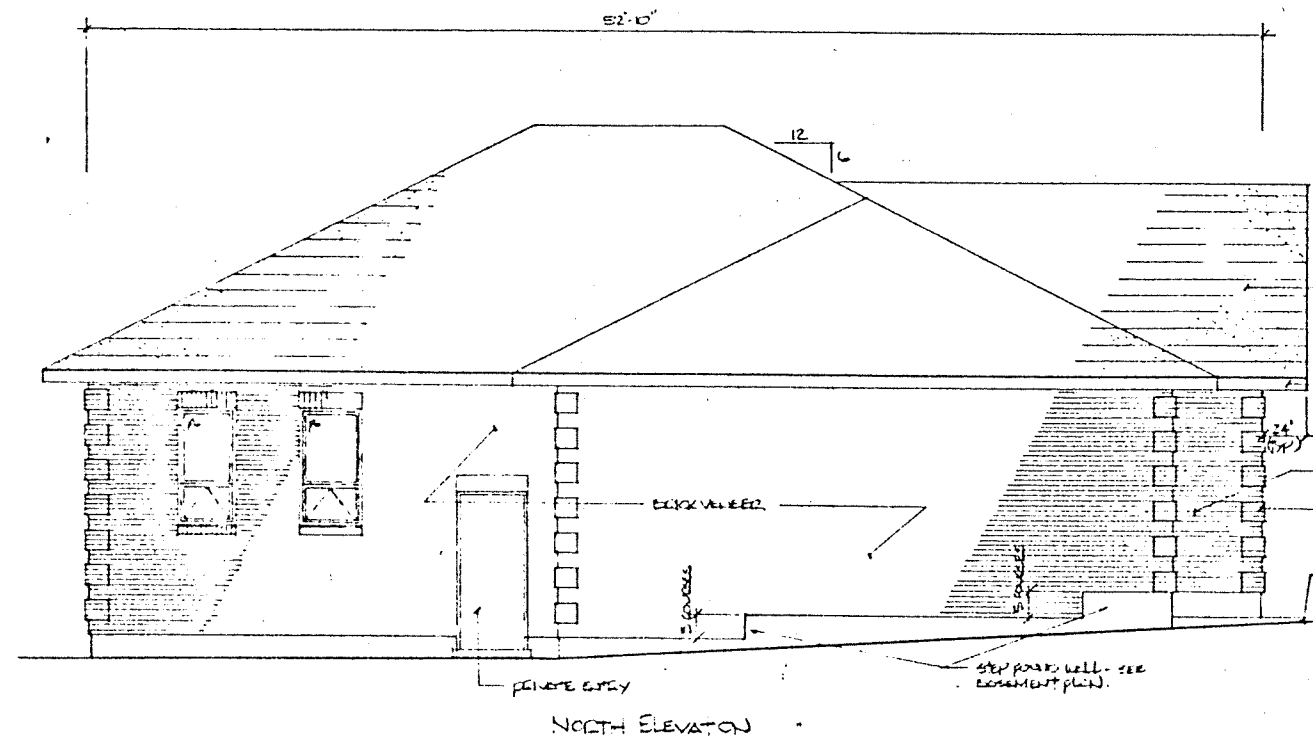


NORTH ELEVATION

- ASHLEY CHIMNEY
- EAVESTROUGH, 6" DIA. 2" DIA. 1" DIA. 1/2" DIA. 1/4" DIA.
- BRICK VENEER
- BRICK CORNELLIA
- PIN WOOD

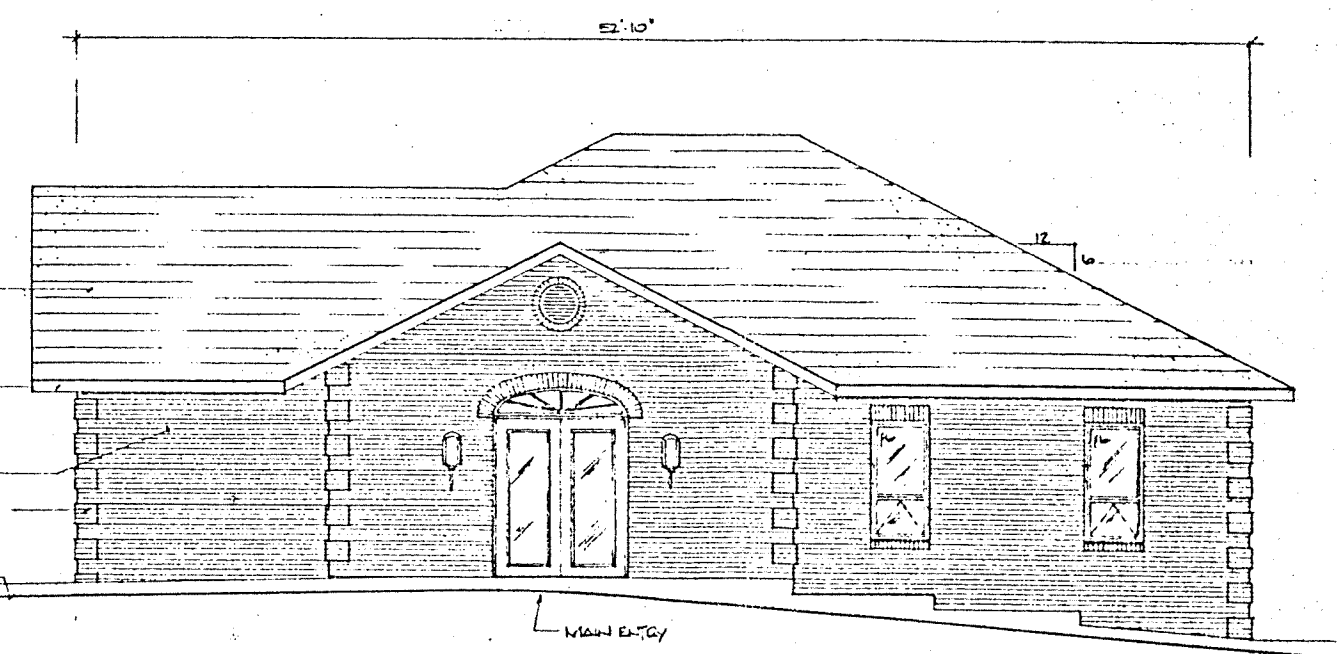


SOUTH ELEVATION

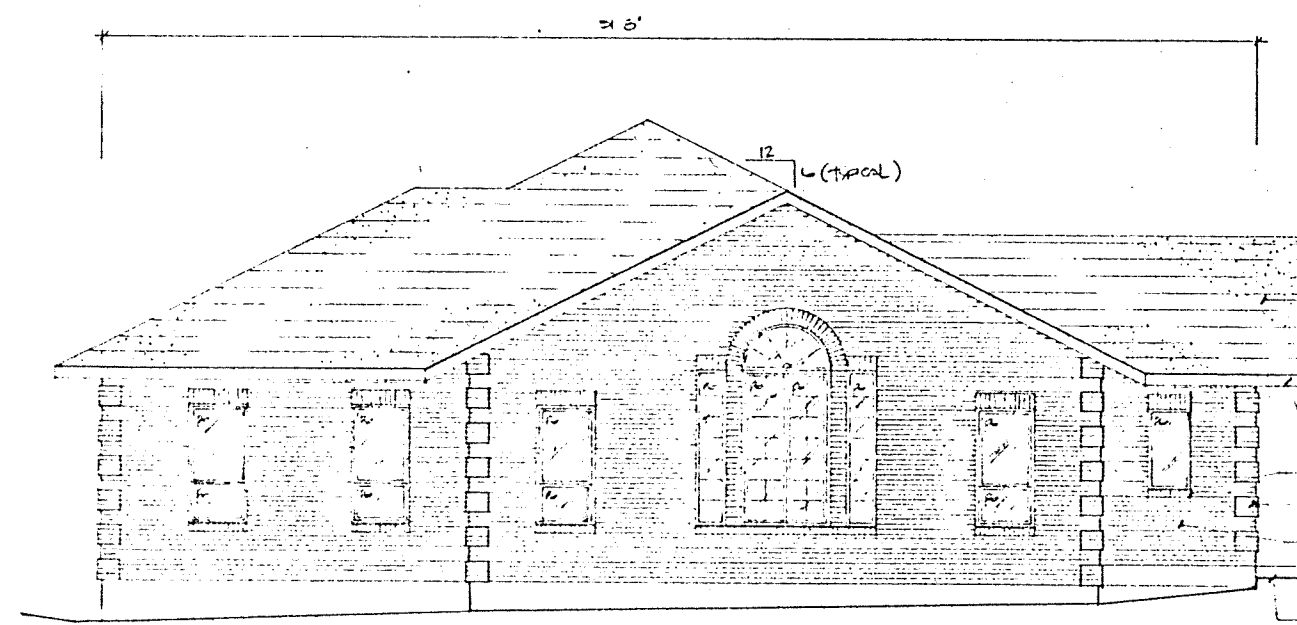

WEST ELEVATION

- ASHLEY CHIMNEY
- EAVESTROUGH, 6" DIA. 2" DIA. 1" DIA. 1/2" DIA. 1/4" DIA.
- BRICK VENEER
- BRICK CORNELLIA
- PIN WOOD


NOTE ABOVE NOTES TYPICAL TO ALL ELEVATIONS

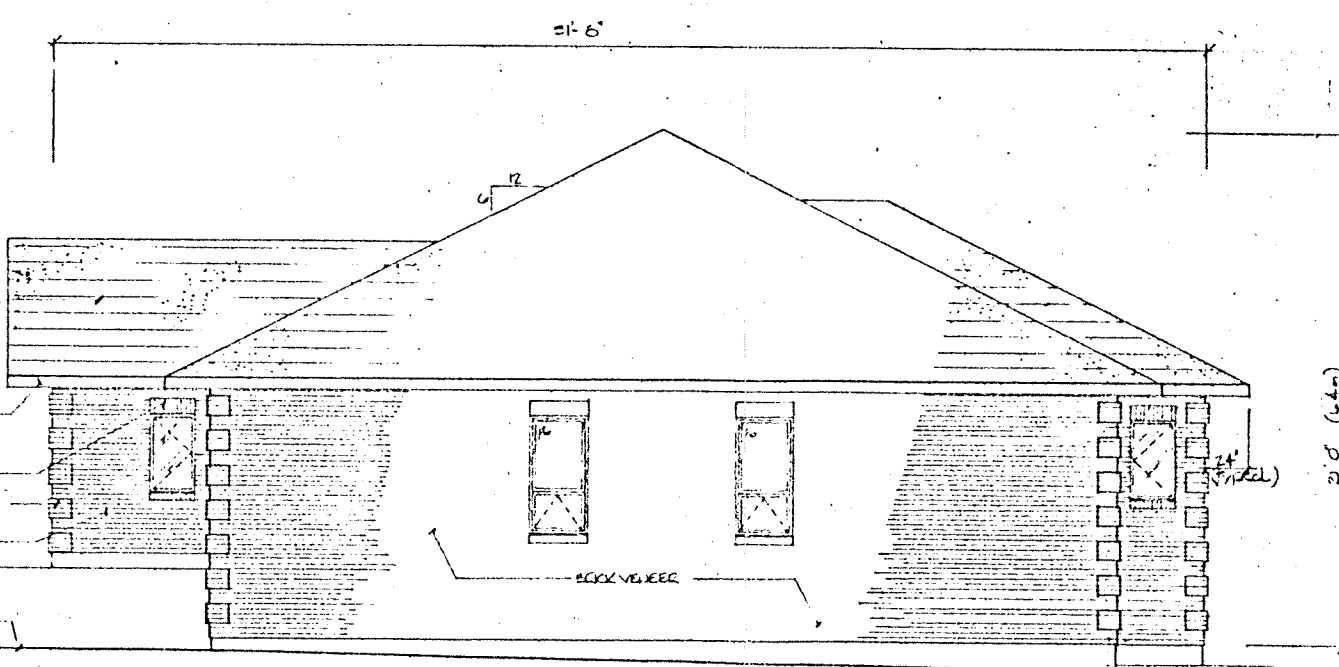

EAST ELEVATION

GREAT SHERBORN DESIGN INC.	
241 RO 4E MILLBROOK, CT. 06040	
FOR	
DR. TIM HENNING &	
CL. AND VOLK-HENNING	
POPTHILL, CT.	
DATE	JULY 6, 1990
SCALE	1/4" = 1'-0"
ALL	A-4

SCHEDULE "C"

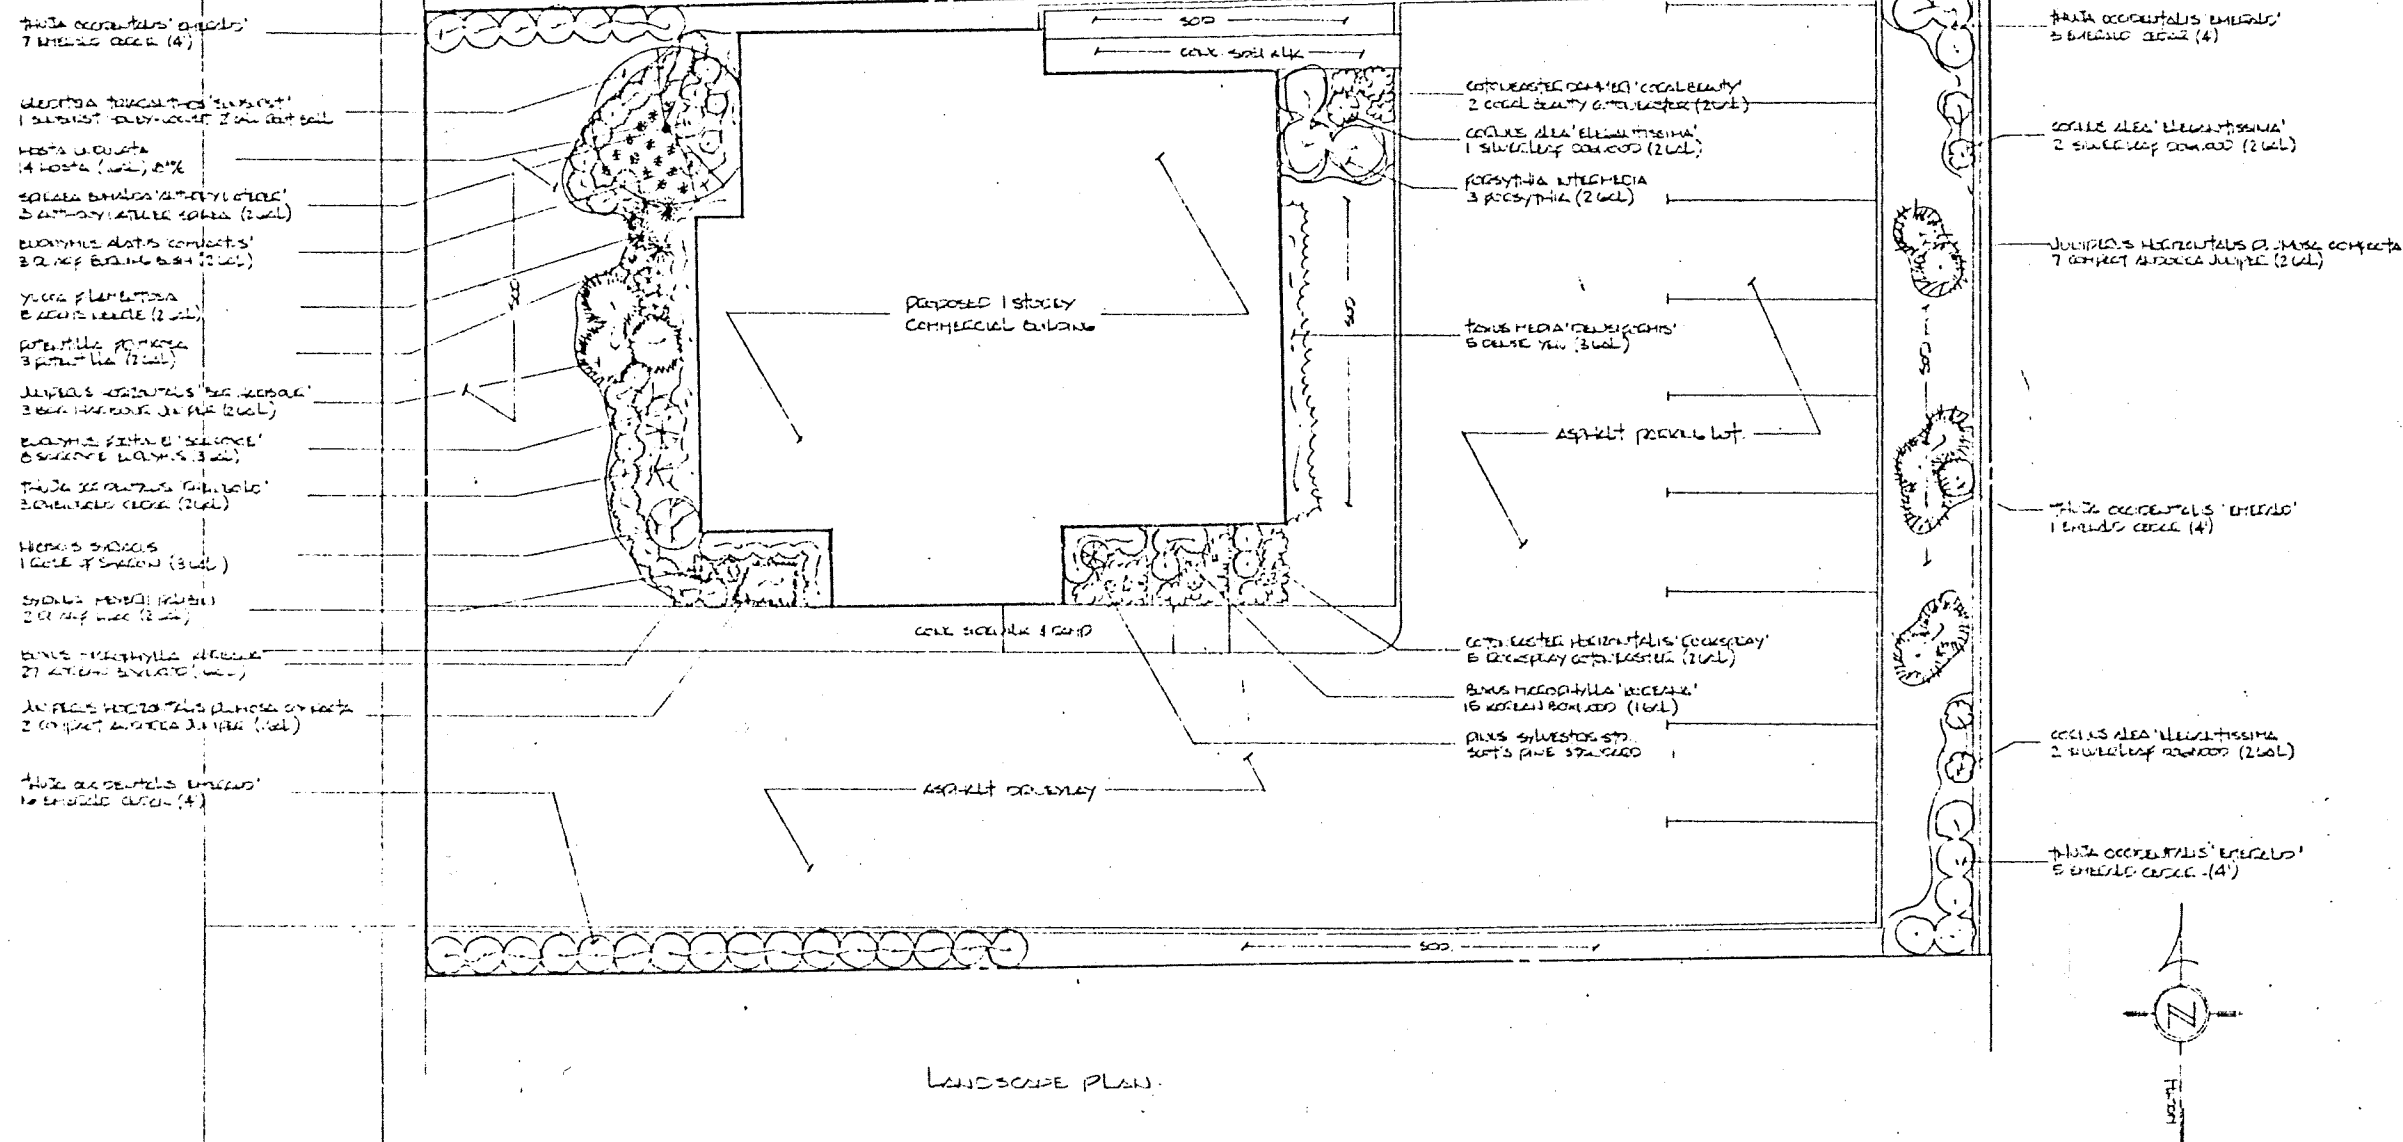

LANDSCAPE PLAN

Comments:
1. Also 22' 00" plan CE again to accommodate changes
from parking area & building footprint

BRANT SOMERVILLE DESIGN INC. 24 26 43 MILLIKEN AVE. LOS ANGELES, CA 90048		
FOR DR. TIM HEJLUND & DR. GUY VILK - HEJLUND		
DATE: JUL 2, 1990		CLB [1]

TIMBER WALL PLAN

DIMENSIONS AS SHOWN

14 TIMBERS HIGH (APPROX 6' HT)

EXISTING BUILDING

NEW PLANTINGS

NEW RIVERS STONE


1"x6" R.T.P. TIE BACK CRIB SYSTEM

NEW TYPED CURBS


NEW TIMBER WALL MEETS EXISTING CONCRETE WALL

TIMBER WALL ELEVATION

DIMENSIONS AS SHOWN

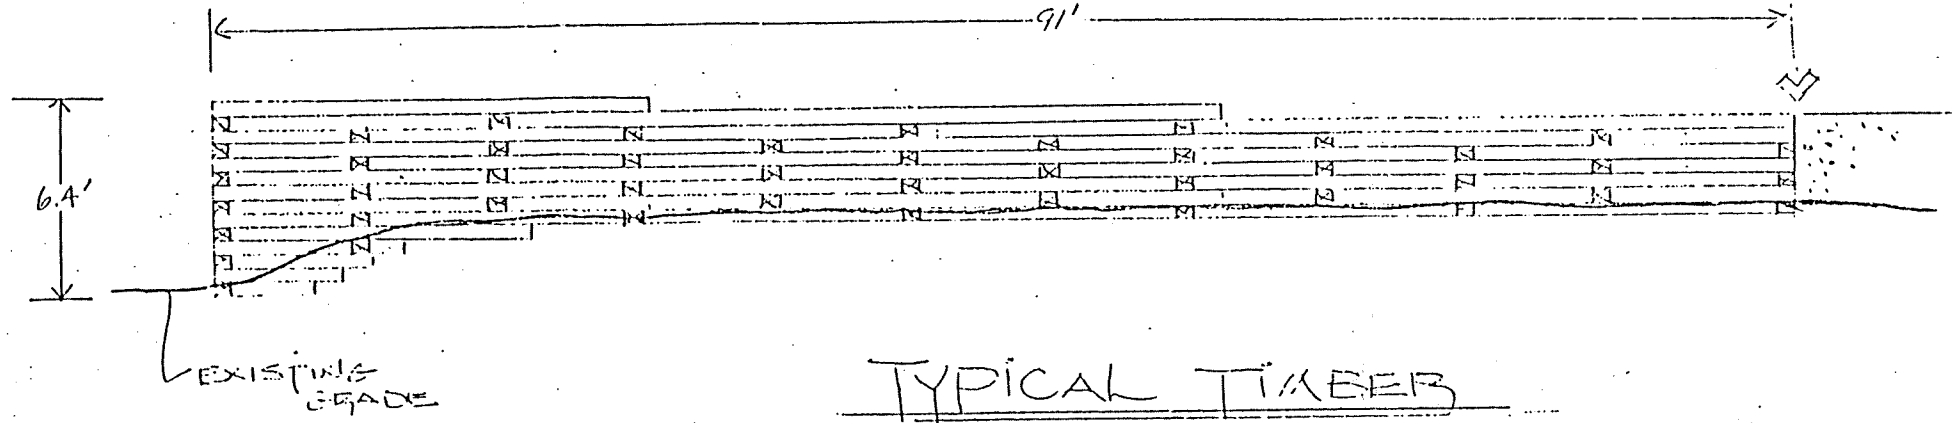

TYPICAL TIMBER WALL SECTION N.T.S.

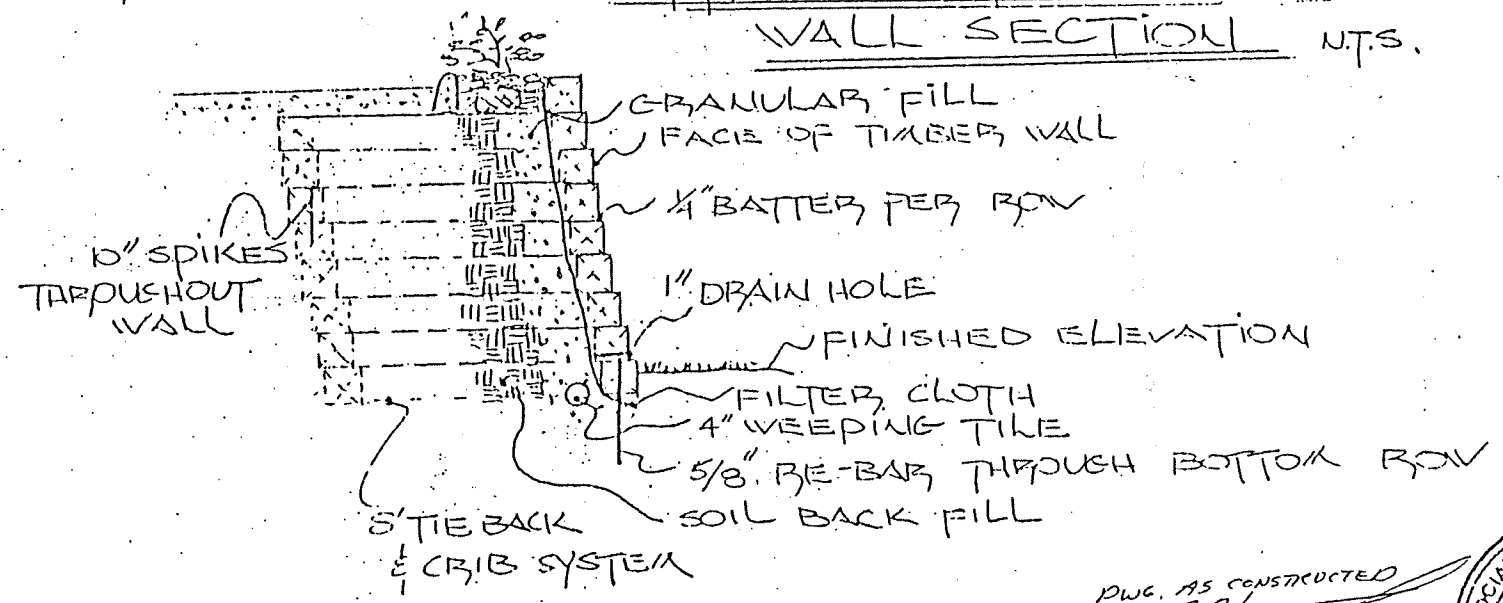

DWG. AS CONSTRUCTED
R. H. HAY
DEC. 21, 1990.



MEDICAL BUILDING DELHAM RD. SOUTH		
SCALE: AS SHOWN	APPROVED BY:	DRAWN BY: B. FREAR
DATE: DEC/90		REVISED
TIMBER WALL PLAN, ELEVATION & DETAIL SECTION.		

SCHEDULE "E"