
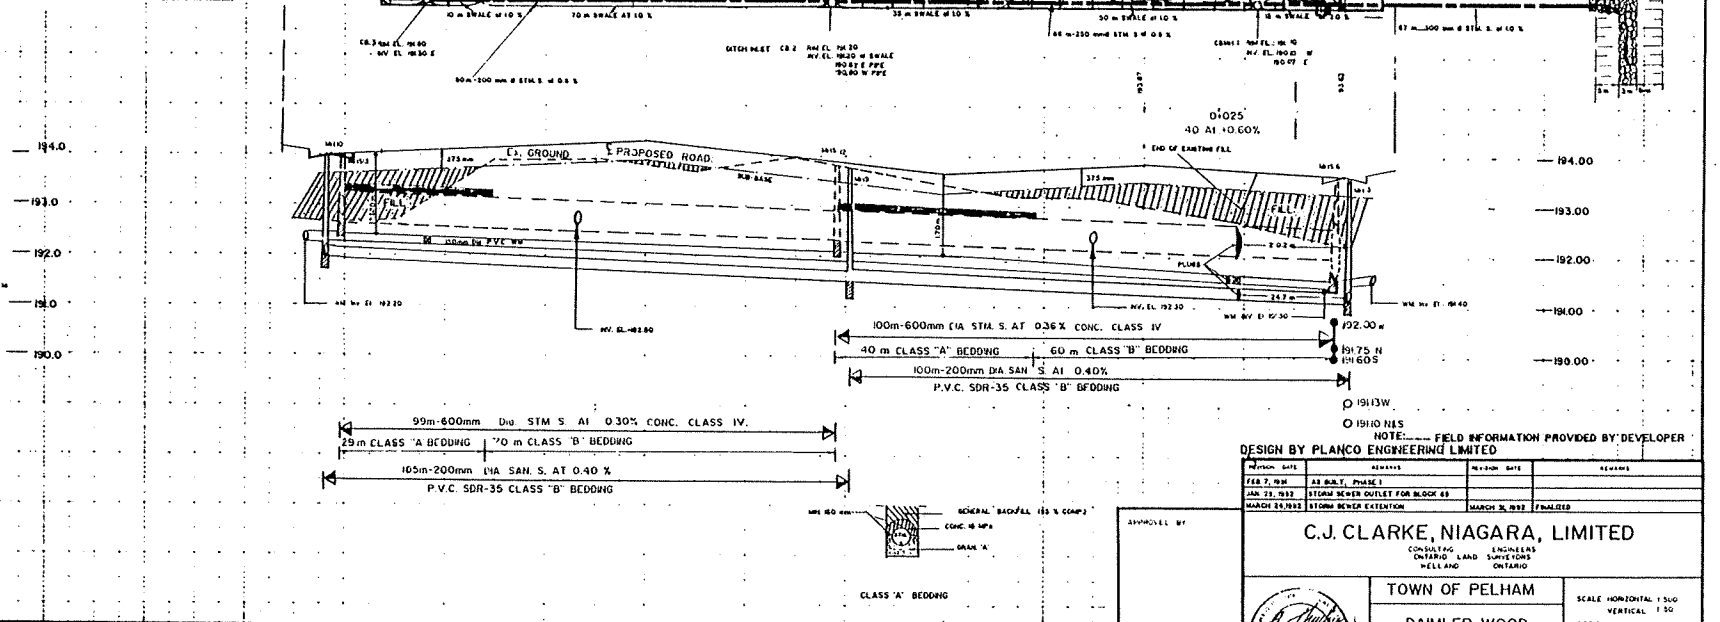
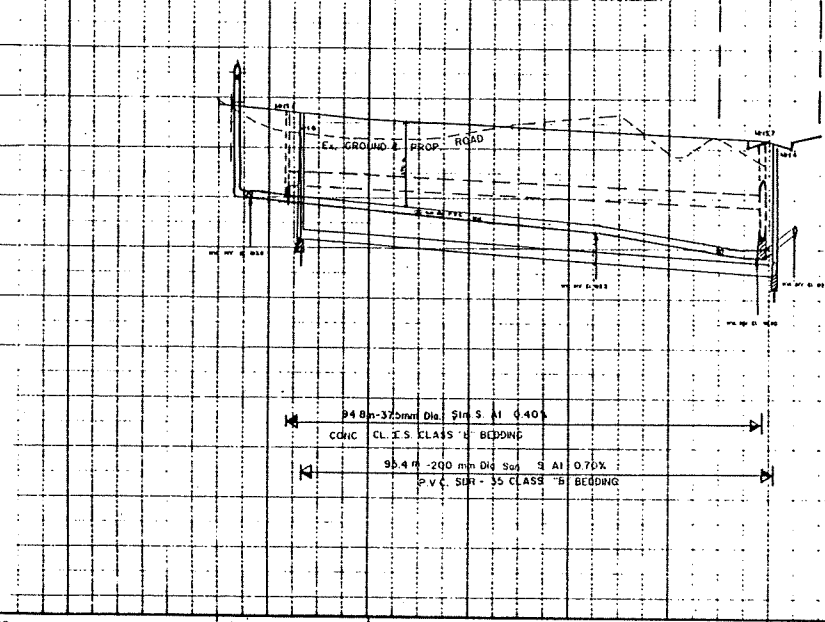


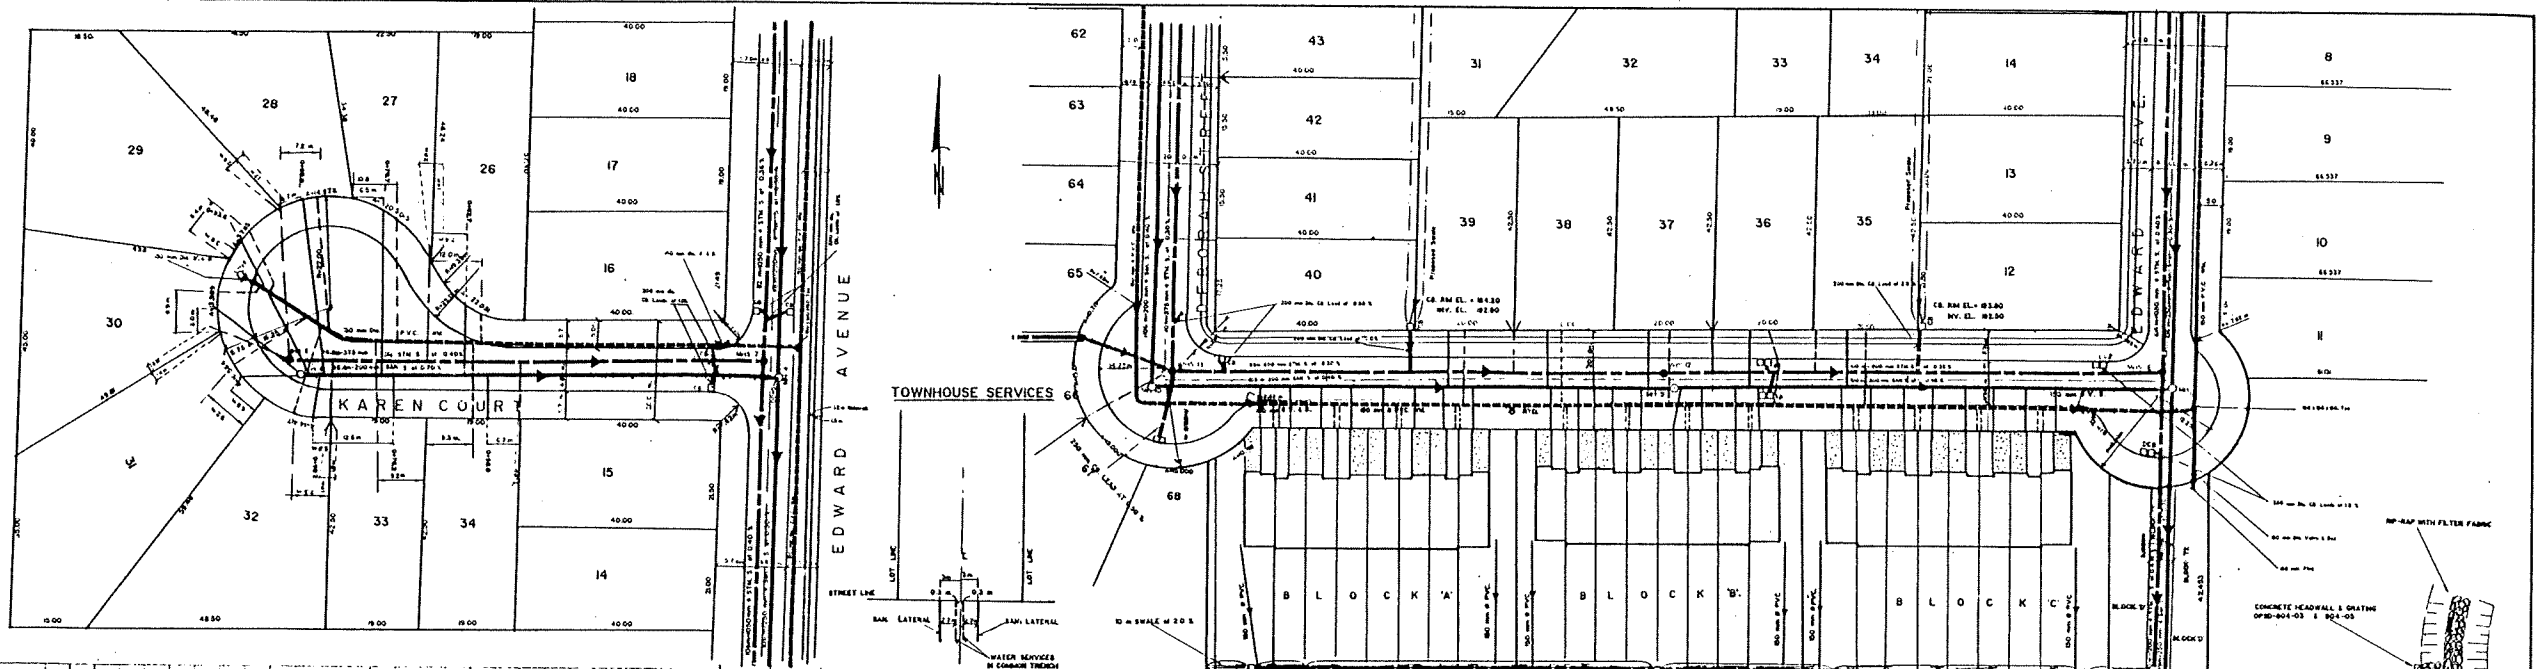

DESIGN BY PLANCO ENGINEERING LIMITED

NOTE: FIELD INFORMATION PROVIDED BY DEVELOPER

DATE	REVISION	REVISION DATE	REVISION
FEB 7, 1983	AS BUILT, PHASE 1		
JAN 23, 1983	STORM SEWER OUTLET FOR BLOCK 85		
MARCH 24, 1983	STORM SEWER EXTENSION	MARCH 24, 1983	FINALIZED

C.J. CLARKE, NIAGARA, LIMITED

ENGINEERS
ONONDAGO COUNTY LAND SURVEYORS
WELLAND, ONTARIO

TOWN OF PELHAM

DAIMLER WOOD
SUBDIVISION

SERVICES TO KAREN COURT,
LAWRENCE LANE (PHASE 2) AND
EDWARD AVENUE PHASE 11

SCALE: HORIZONTAL 1"=50'
VERTICAL 1"=50'

DESIGN - A. PLUMMER
DRAWN - ADRIAN PLUMMER
CHECKED - ANDREW PLUMMER
DATE - JAN 1983
PROJECT NO. - 83-231
DRAWING AT - 3