

Schedule "A"


PIN 64072-0780 (LT)

Block 13, Plan 59M-406; Subject to an Easement in Gross over
Part of Block 13; Plan 59M-406 being Parts 8, 9 & 10 on 59R-
15100 as in SN403733; Town of Pelham.

[2, 4, and 6 Brayden Way]


SCHEDULE 'H': SITE PLAN

Streetscape (plan: 1479-BLOCK13), prepared by Upper Canada Consultants, dated February 3, 2015, revised April 13, 2015.

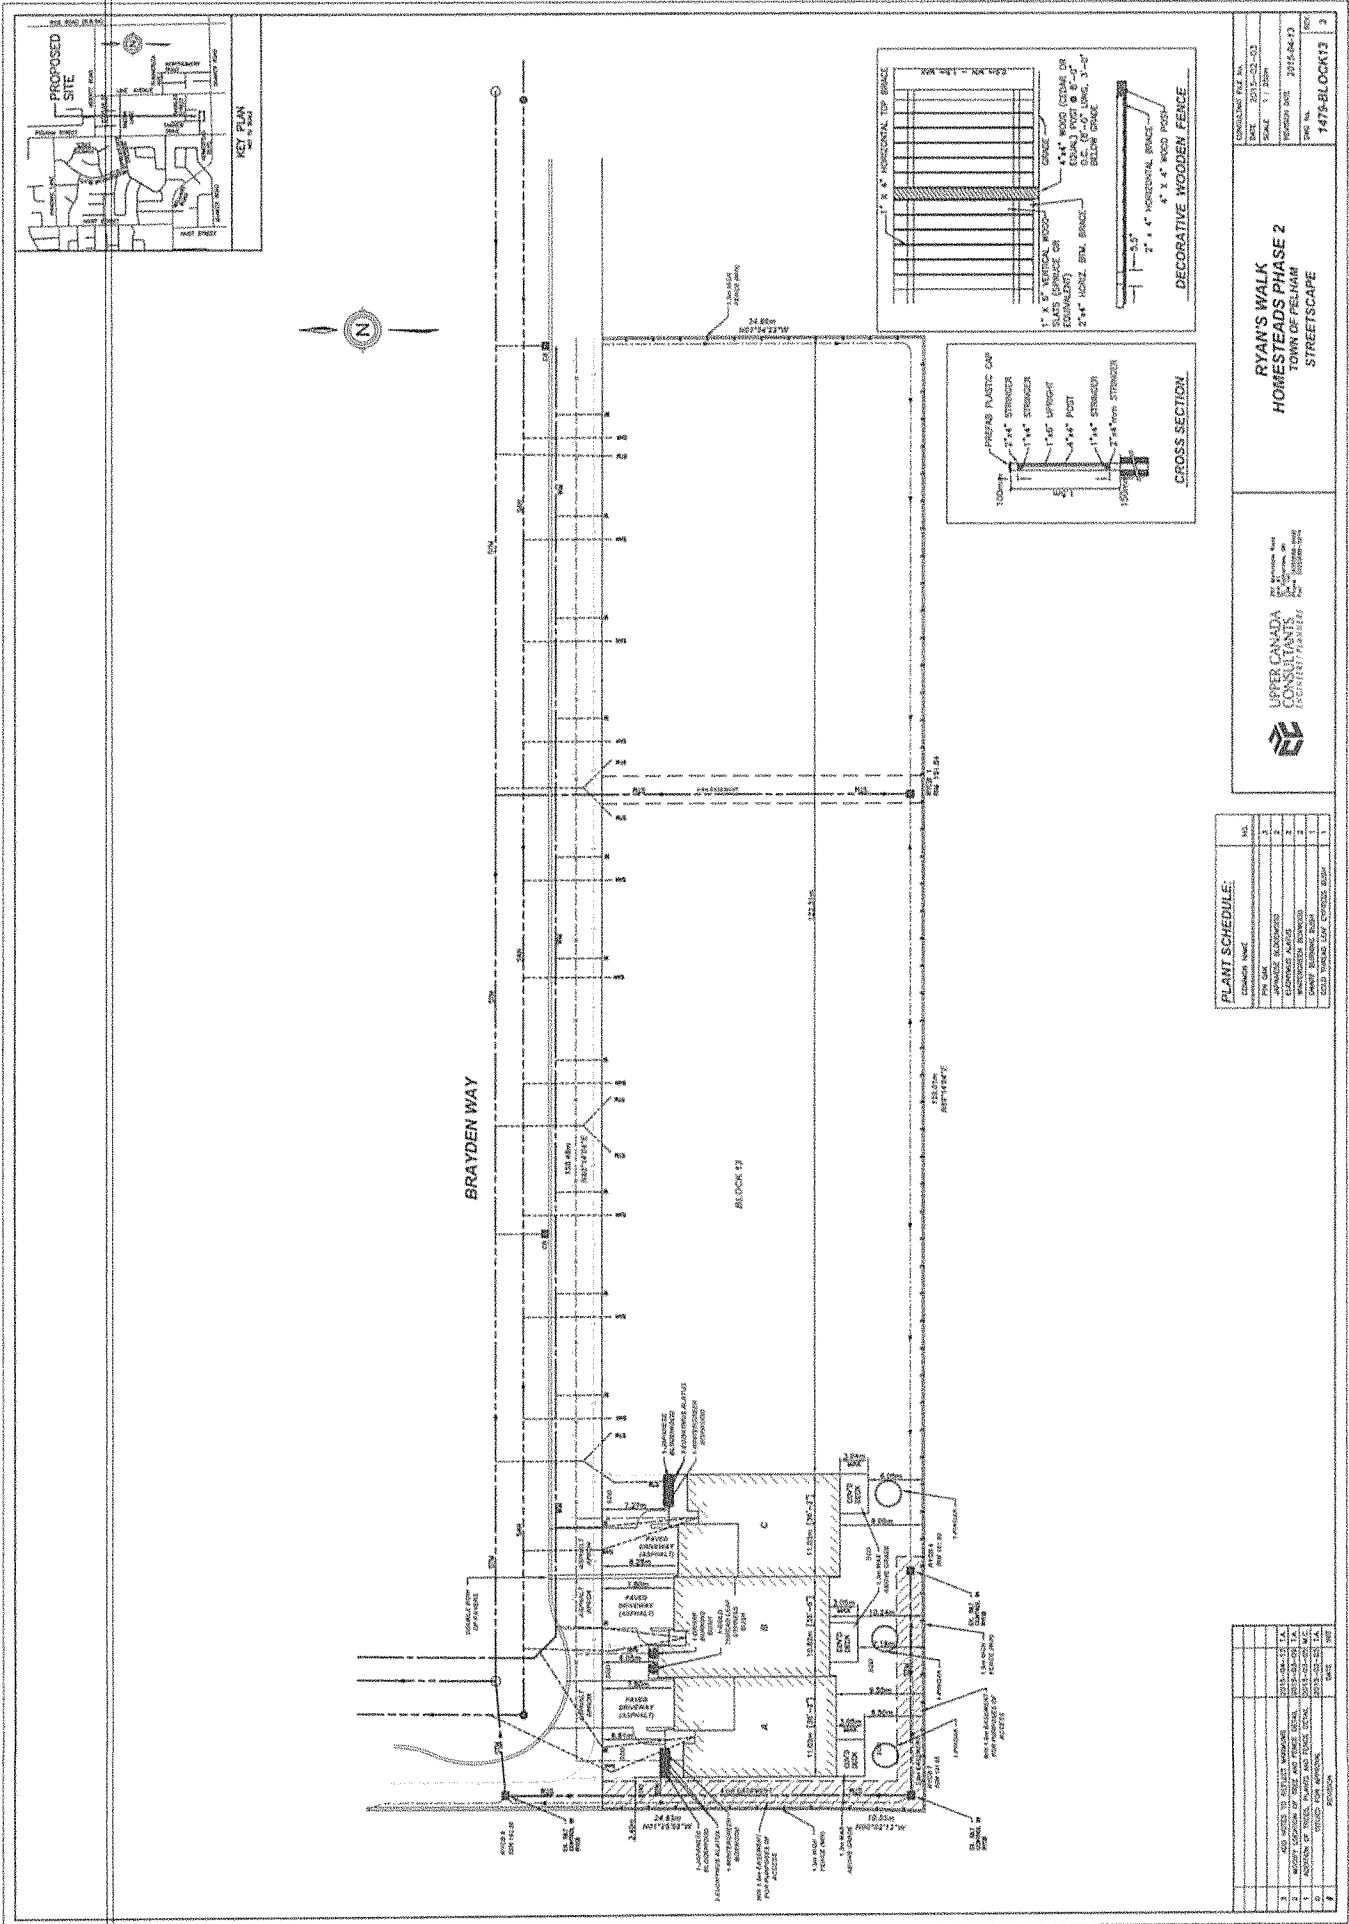

SCHEDULE 'I': SITE ELEVATION PLANS



Front and Right Elevations, Exterior 3D Perspectives (plan: A2), prepared by Corriveau Cadd, dated December 2014, red line revised April 14, 2015.

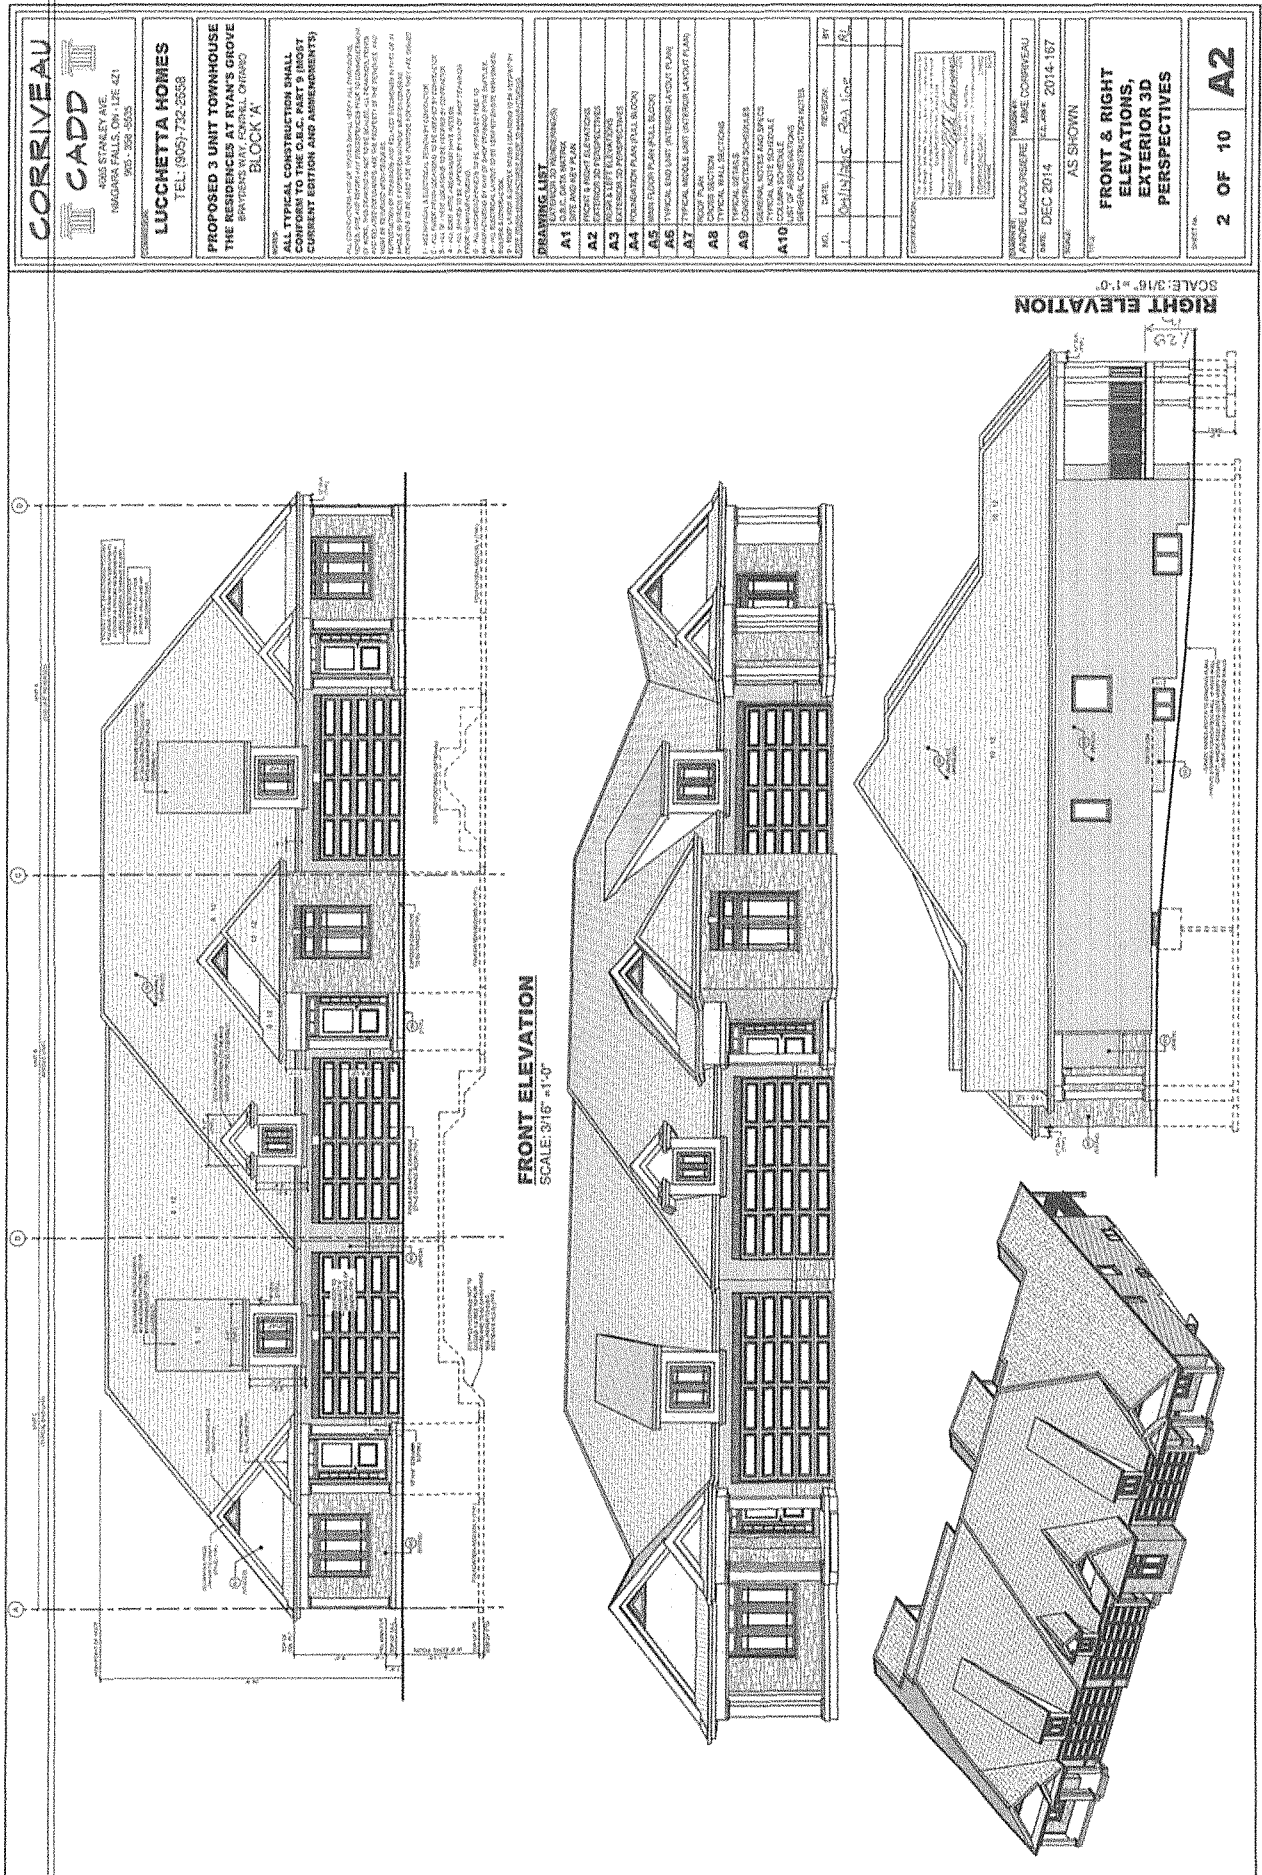


Rear and Left Elevations, Exterior 3D Perspectives (plan: A3), prepared by Corriveau Cadd, dated December 2014, red line revised April 14, 2015.

[illegible]

LEFT ELEVATION
SCALE: 3/16" = 1'-0"

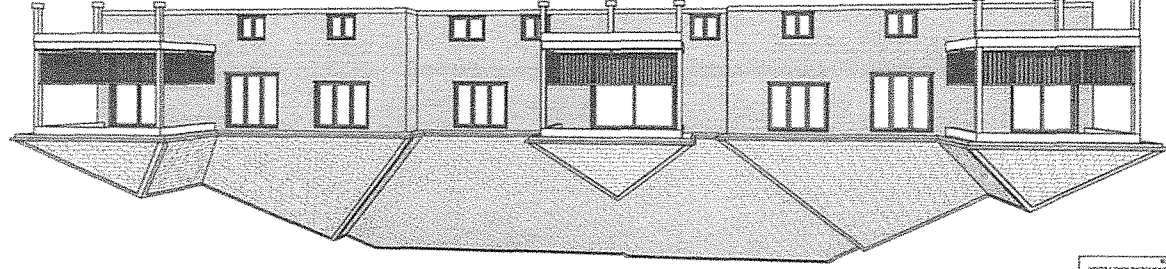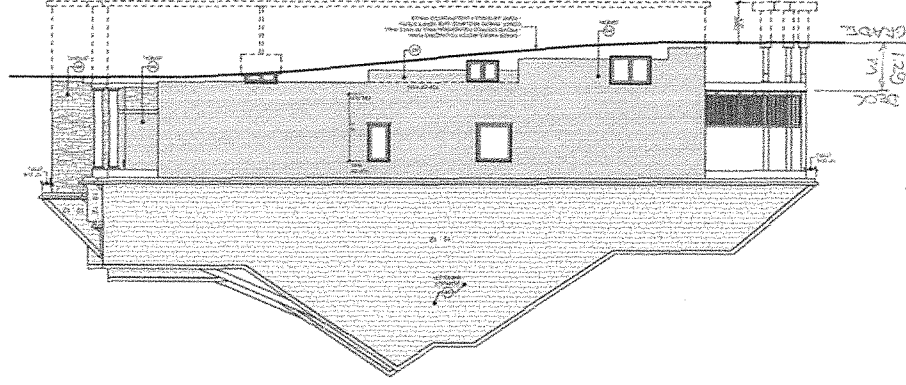

REAR ELEVATION
SCALE: 3/16" = 1'-0"

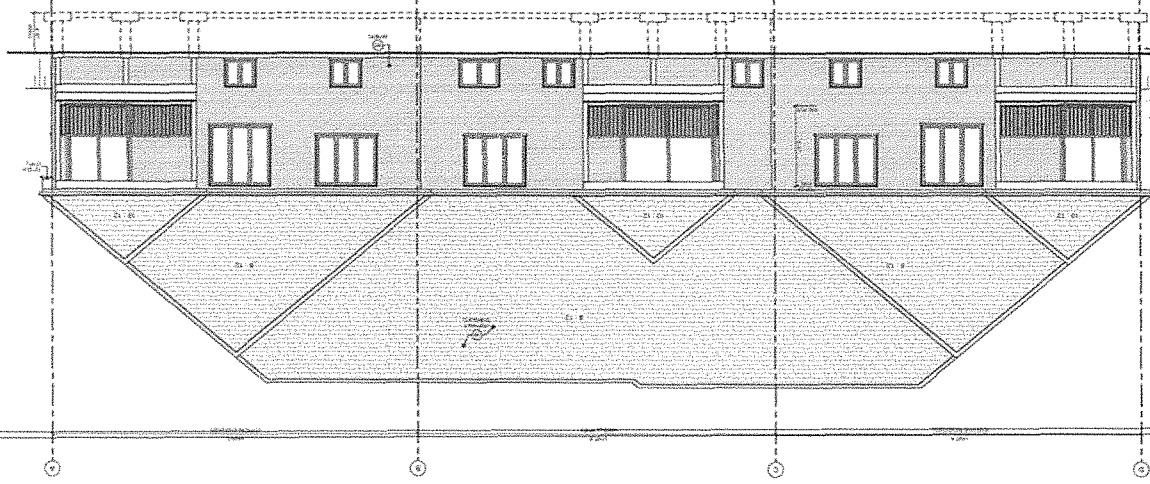

Note:
MAX ALLOWABLE
DROK TO GRADE
DIFFERENCE
1.3m

The diagram consists of two horizontal lines. The top line is labeled 'GRADE HEIGHT' and the bottom line is labeled 'DECK HEIGHT'. A vertical double-headed arrow between these two lines is labeled '1.20 m'.

14-00000